


A-105
Cantor Fitzgerald
New Corporate Bond Trading Room
105F-11

DRAWING NUMBER

DRAWING NUMBER

DRAWING NUMBER

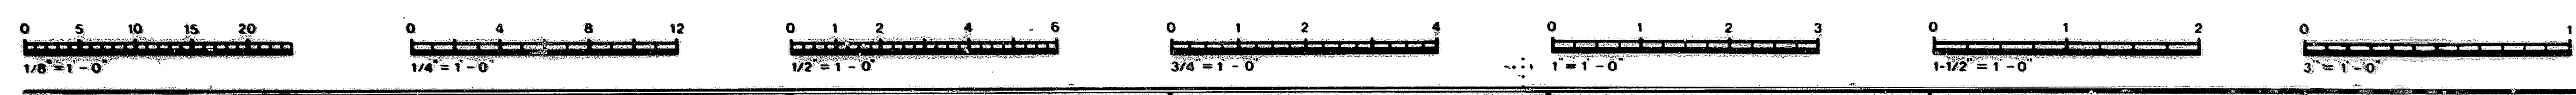

IF THIS DRAWING IS NOT 24"x36" IT IS A REDUCED PRINT SCALE ACCORDINGLY



CHARLES D. FLAYHAN ASSOCIATES INC.
880 CANAL STREET STAMFORD, CT. 06902
203 348-4300

| DATE | ISSUED TO | PR. | TR. |
|---------|--|-----|-----|
| 12-7-84 | POST AUTHORITY FOR APPROVAL CIVILS CORP. FOR THIS C.F.A.C. FOR RECORD | 10 | 1 |
| 1-18-85 | POST AUTHORITY FOR APPROVAL CIVILS CORP. FOR INFORMATION C.F.A.C. FOR RECORD | 10 | 1 |
| 5-9-85 | POST AUTHORITY "AS BUILT" | 0 | 2 |

PHASE
F
TAA NO. 3104
AS BUILT DWG
5-1-85

AS-BUILT DRAWING



| | | | |
|-----------------|------|----------|----|
| DATE _____ | | | |
| INSPECTOR _____ | | | |
| | | | |
| | | | |
| NO. | DATE | REVISION | BY |
| | | | |

CANTOR, FITZGERALD
SECURITIES CORP.
105th FLOOR
ONE WORLD TRADECENTER, NEW YORK N.Y.

NEW CORPORATE BOND
TRADING ROOM
DETAILS FOR TRADING
DESKS

PROJECT NO. 1357A
SCALE AS NOTED
DRAWN BY J.F.P.
CHECKED BY
DATE 12-6-84

DRAWING NO.
105F
11

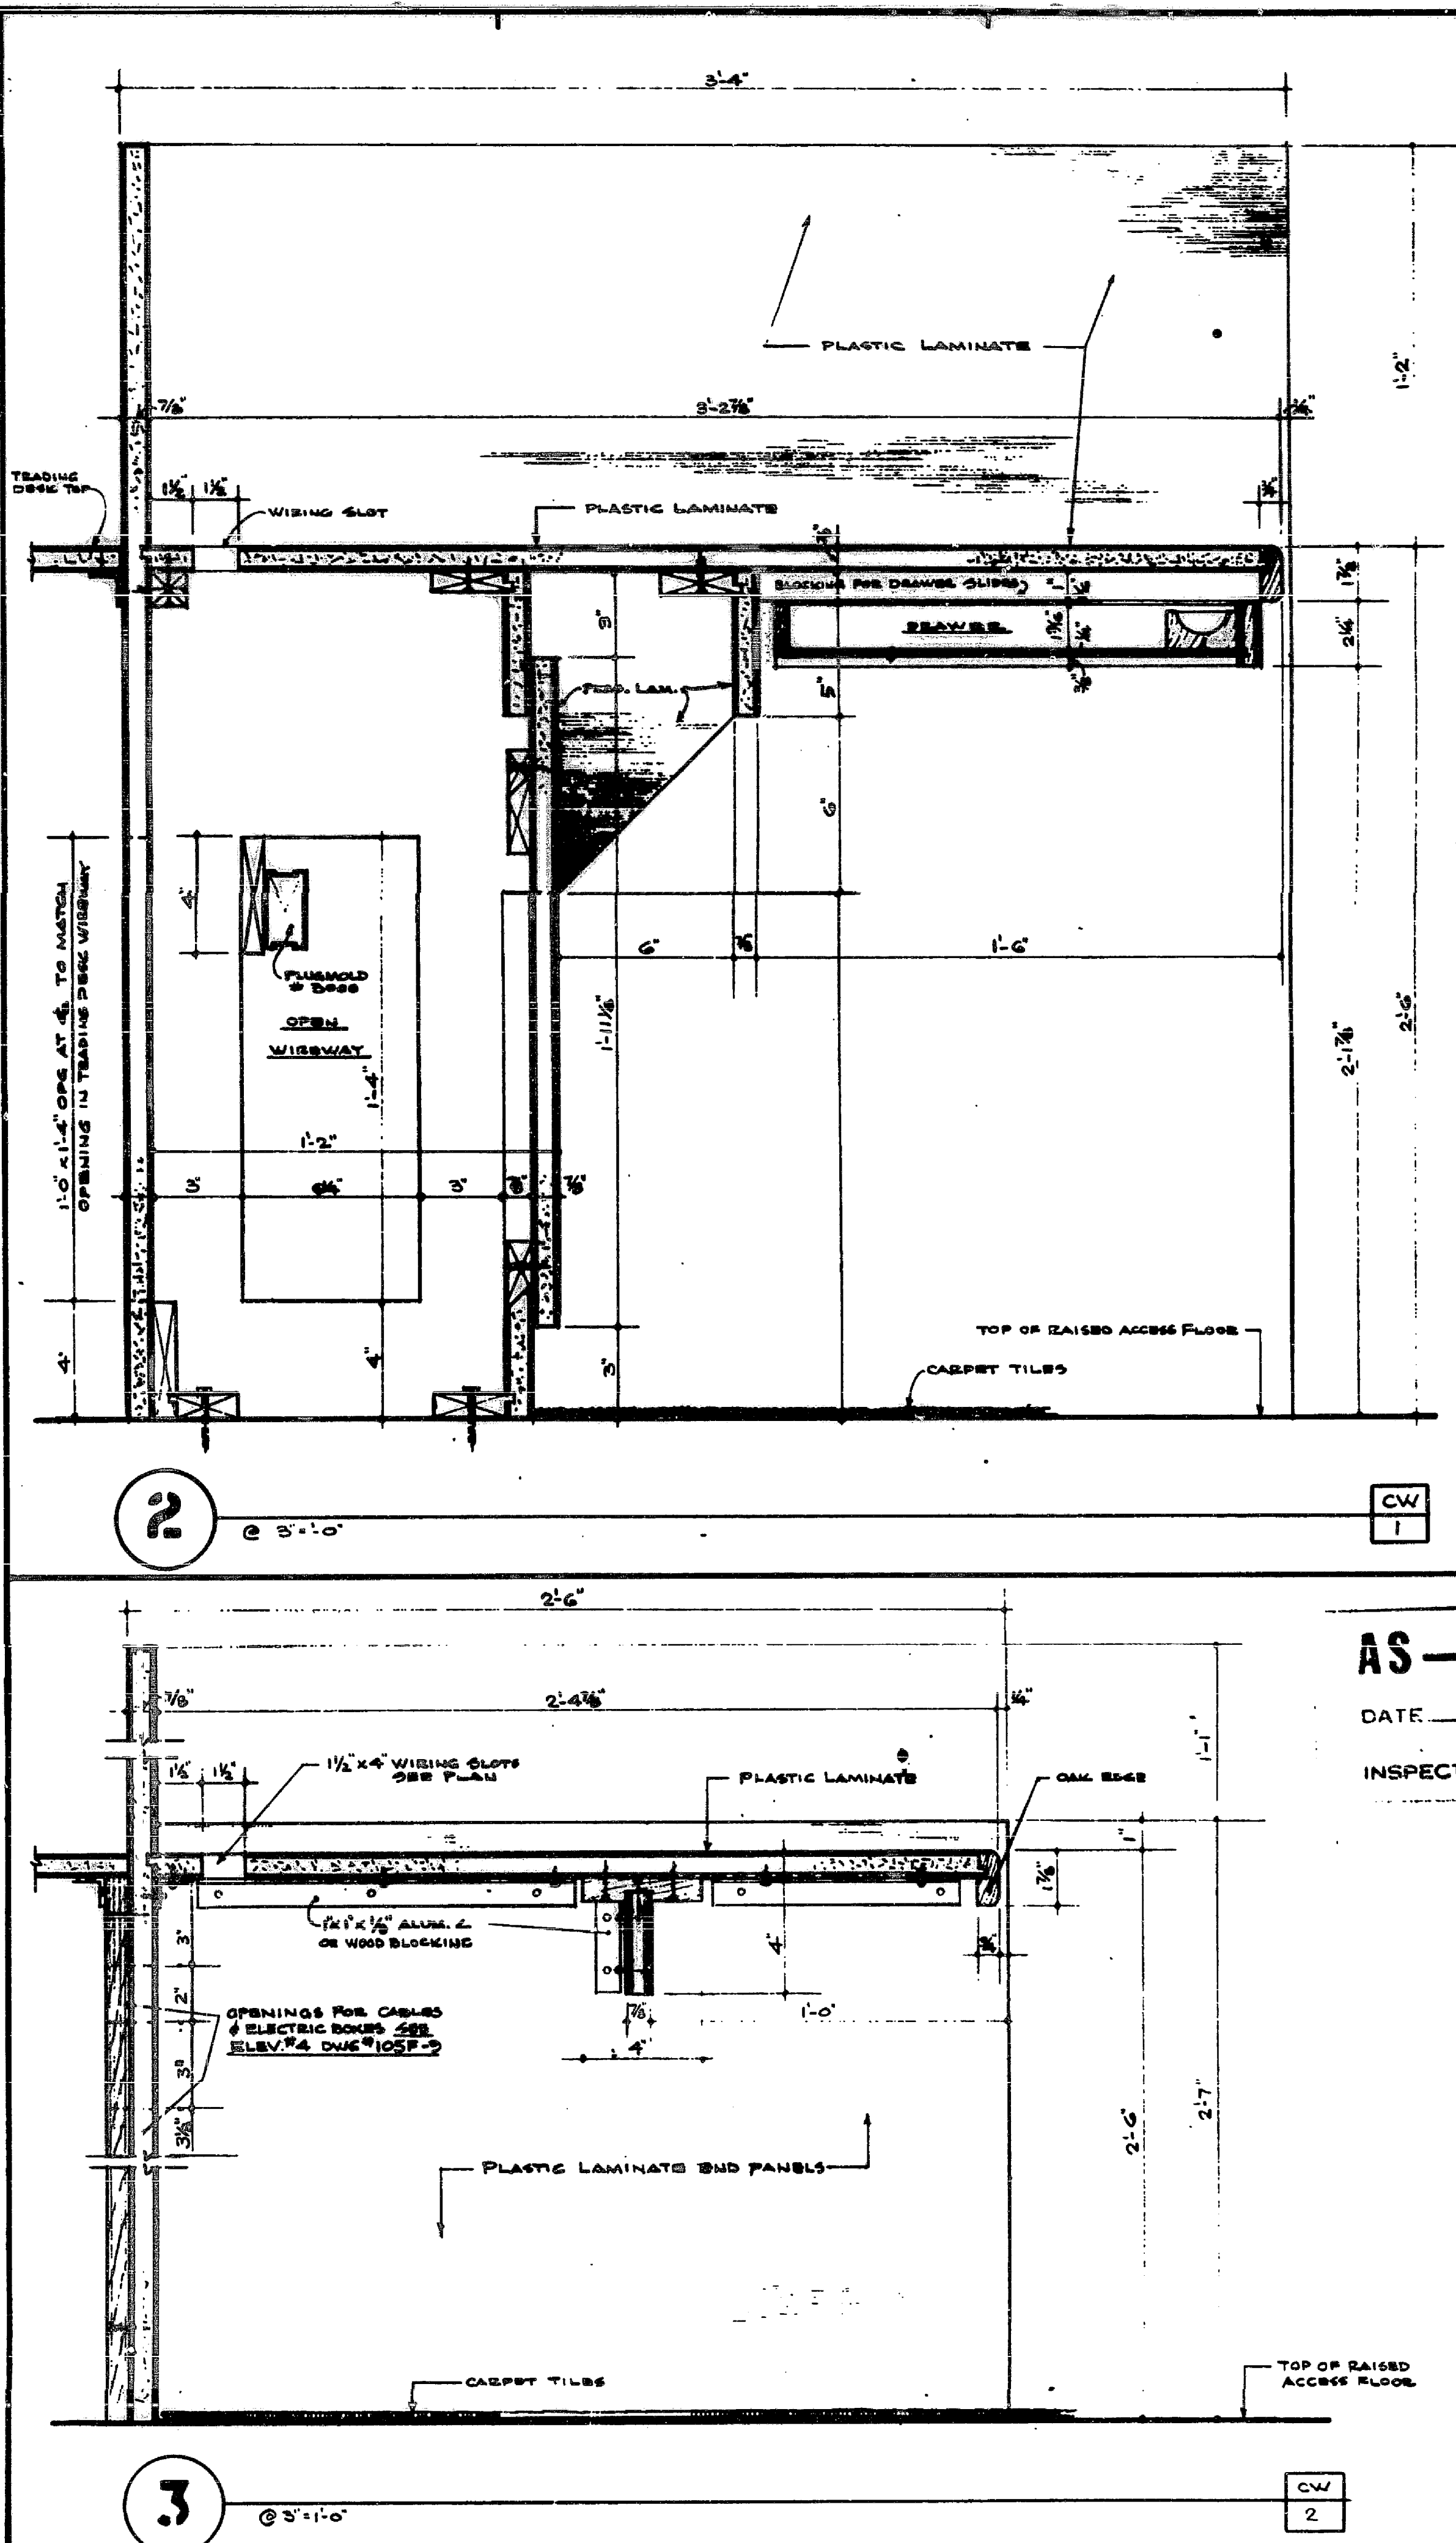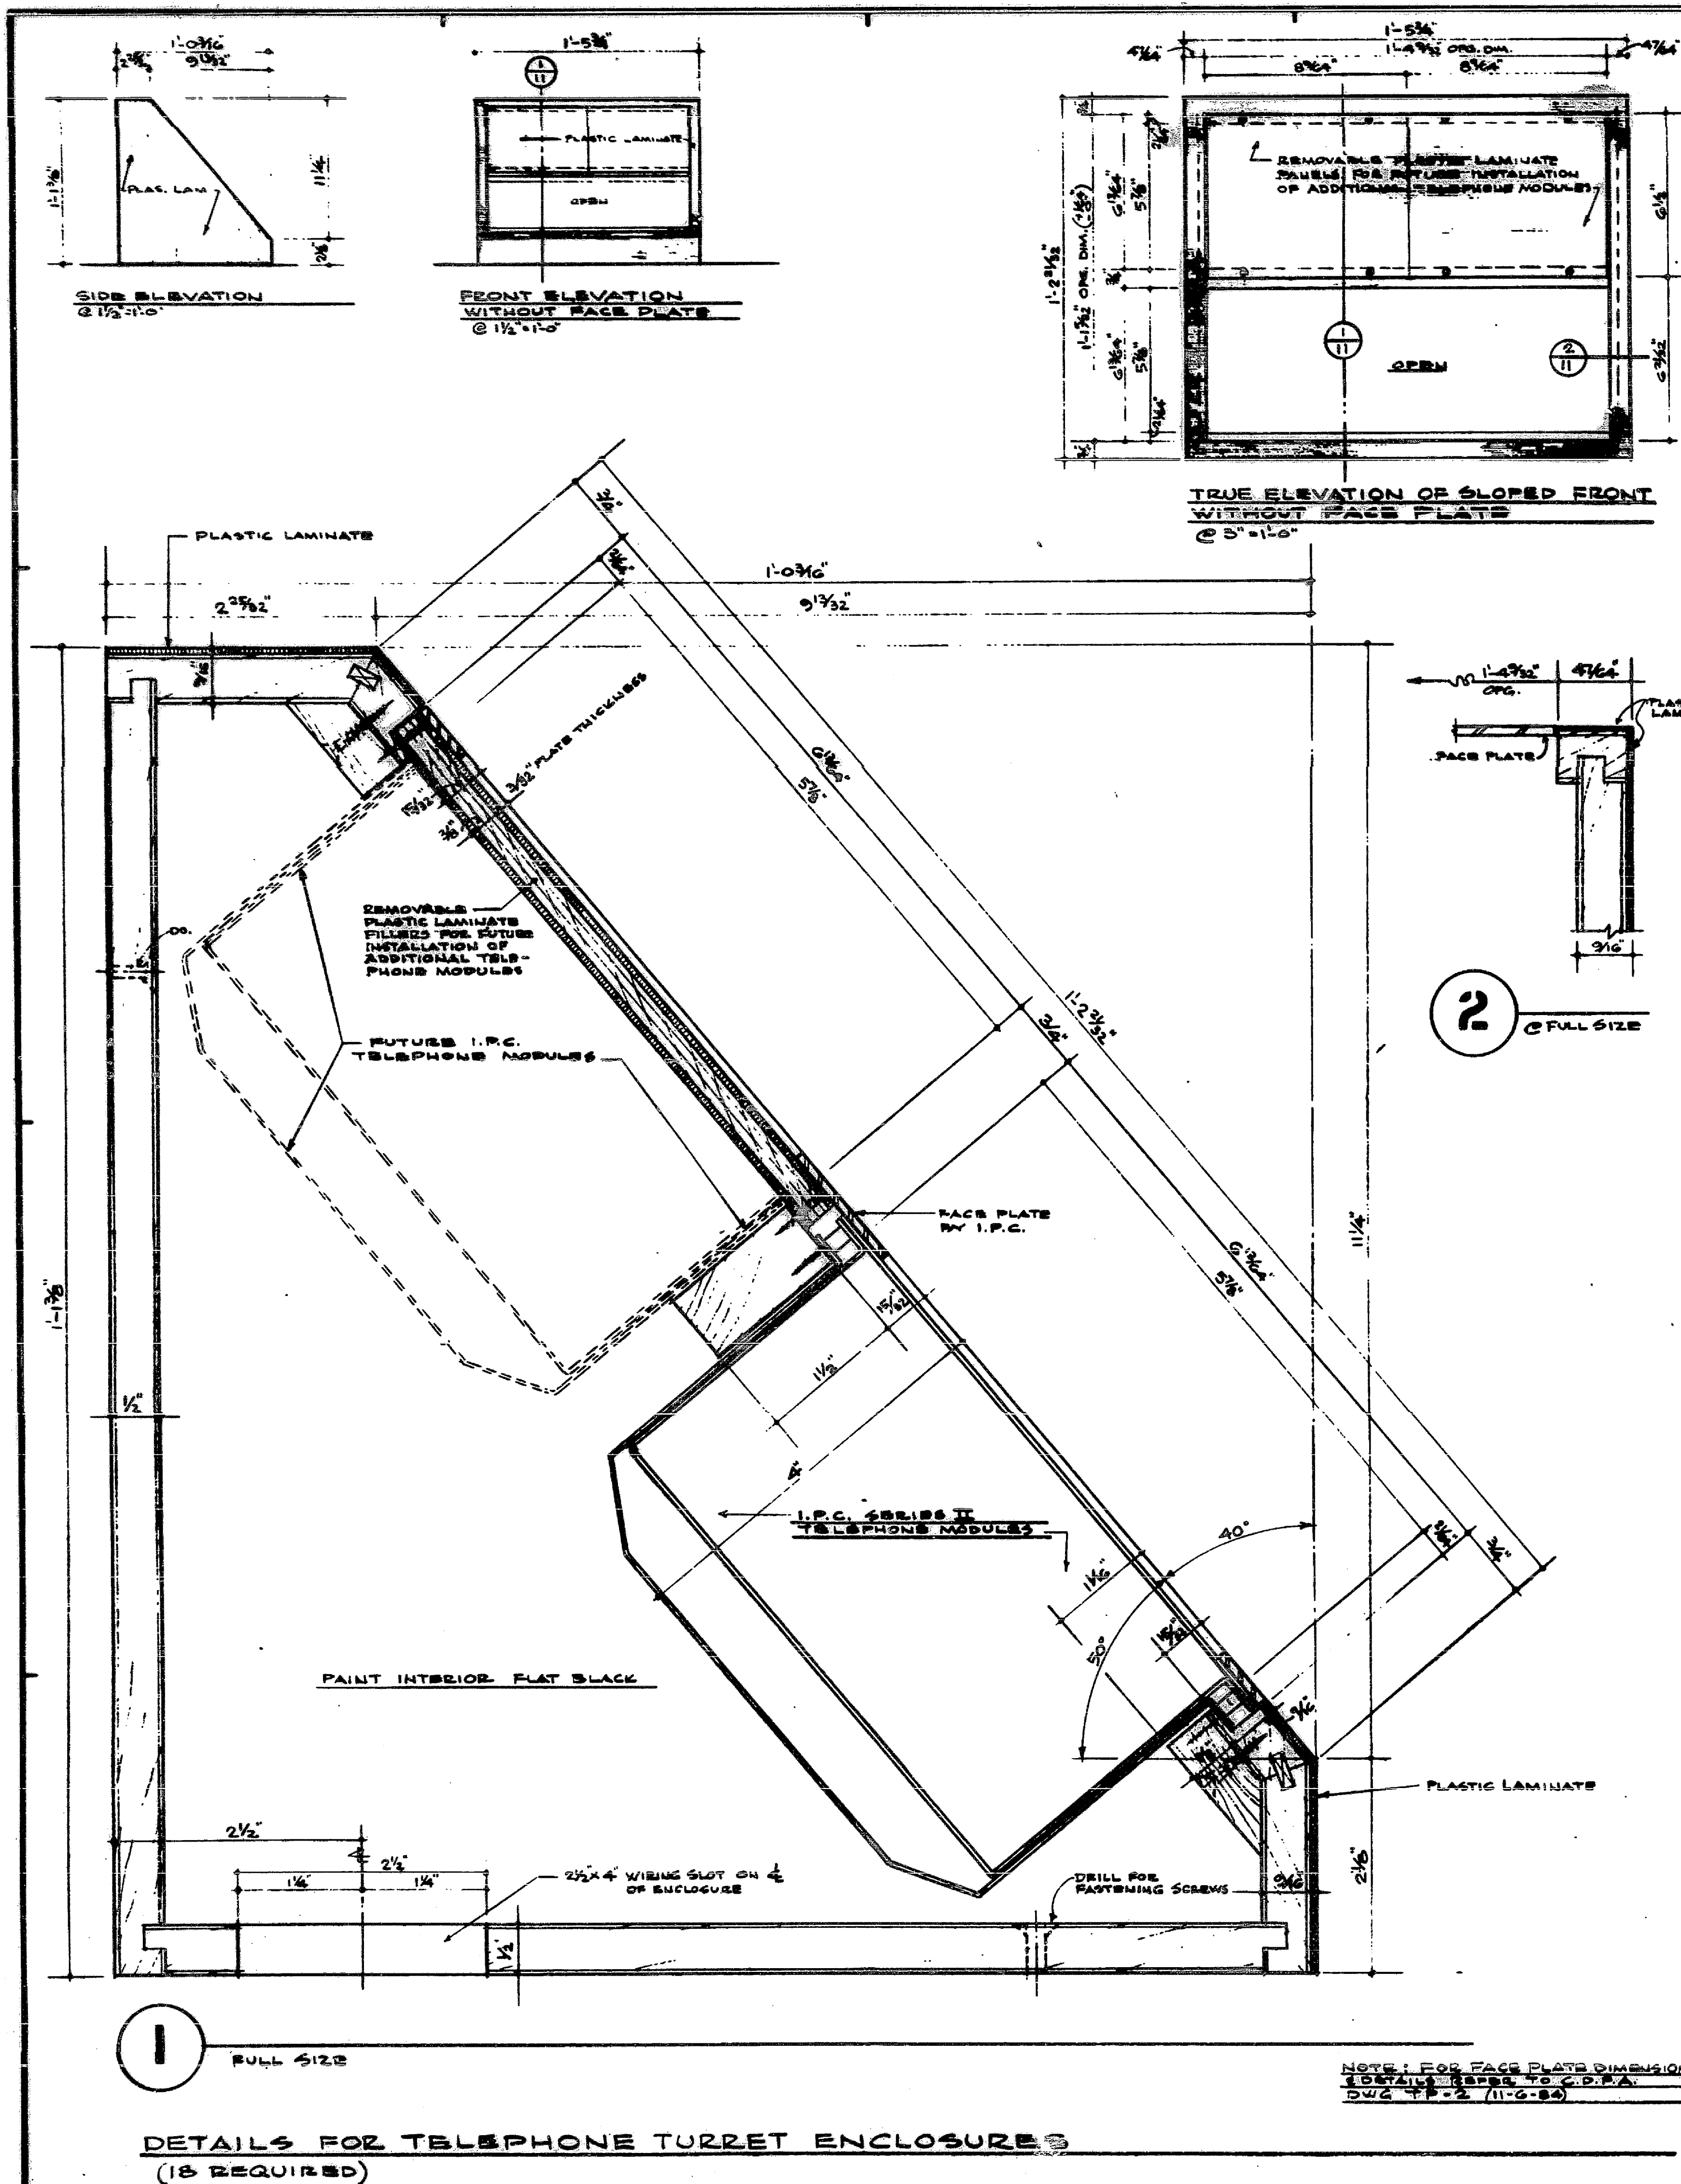

DETAILS FOR TELEPHONE TURRET ENCLOSURES
(18 REQUIRED)

NOTE: FOR FACE PLATE DIMENSIONS
REFER TO C.F.A.
DWG. 105F-11 (12-6-84)